

NOTES:

I CERTIFY THAT THE "AS CONSTRUCTED" DETAILS SHOWN ON THIS PLAN ARE A TRUE AND ACCURATE RECORD OF THE WORKS SHOWN HEREON, AS THEY WERE SURVEYED BY US ON SITE.

SIGNED *Donald McCall Mackie* DATE 3/3/09
Donald McCall Mackie (CAD. Surv.)

for Walter Consulting Group.

LEVEL DATUM AND vide PSM 40521
ADOPTED LEVEL: 105 068m AND Derived
LOCATION:



"WORKS AS CONSTRUCTED"
[Signature]
DATE 6/3/09
DYACON ENGINEERS PTY LTD

SURVEYED BE
DRAWN BAW
DATE 16/10/09



LICENCED SURVEYORS TOWN PLANNERS
DEVELOPMENT CONSULTANTS
SUITE 1
30 FLORENCE ST. (07) 36665200
NEWSTEAD F (07) 36665202
P.O. Box 436

DRAWING TITLE

JOB NUMBER
C1340
DRAWING NUMBER



NOTES:

I CERTIFY THAT THE "AS CONSTRUCTED" DETAILS SHOWN ON THIS PLAN ARE A TRUE AND ACCURATE RECORD OF THE WORKS SHOWN HEREON, AS THEY WERE SURVEYED BY US ON SITE.

SIGNED *Donald McCall Mackie* DATE 3/3/09
Donald McCall Mackie (CAD. Surv.)

for Walter Consulting Group.

LEVEL DATUM AND vide PSM 40521
ADOPTED LEVEL: 105.068m AND Derived
LOCATION:



"WORKS AS CONSTRUCTED"
[Signature]
DATE 6/3/09
DYACON ENGINEERS PTY LTD


SURVEYED BE
DRAWN BAW
DATE 16/10/09



LICENCED SURVEYORS TOWN PLANNERS
DEVELOPMENT CONSULTANTS
SUITE 1
30 FLORENCE ST. (07) 36665200
NEWSTEAD F (07) 36665202
P.O. Box 436

DRAWING TITLE

JOB NUMBER
C1340
DRAWING NUMBER

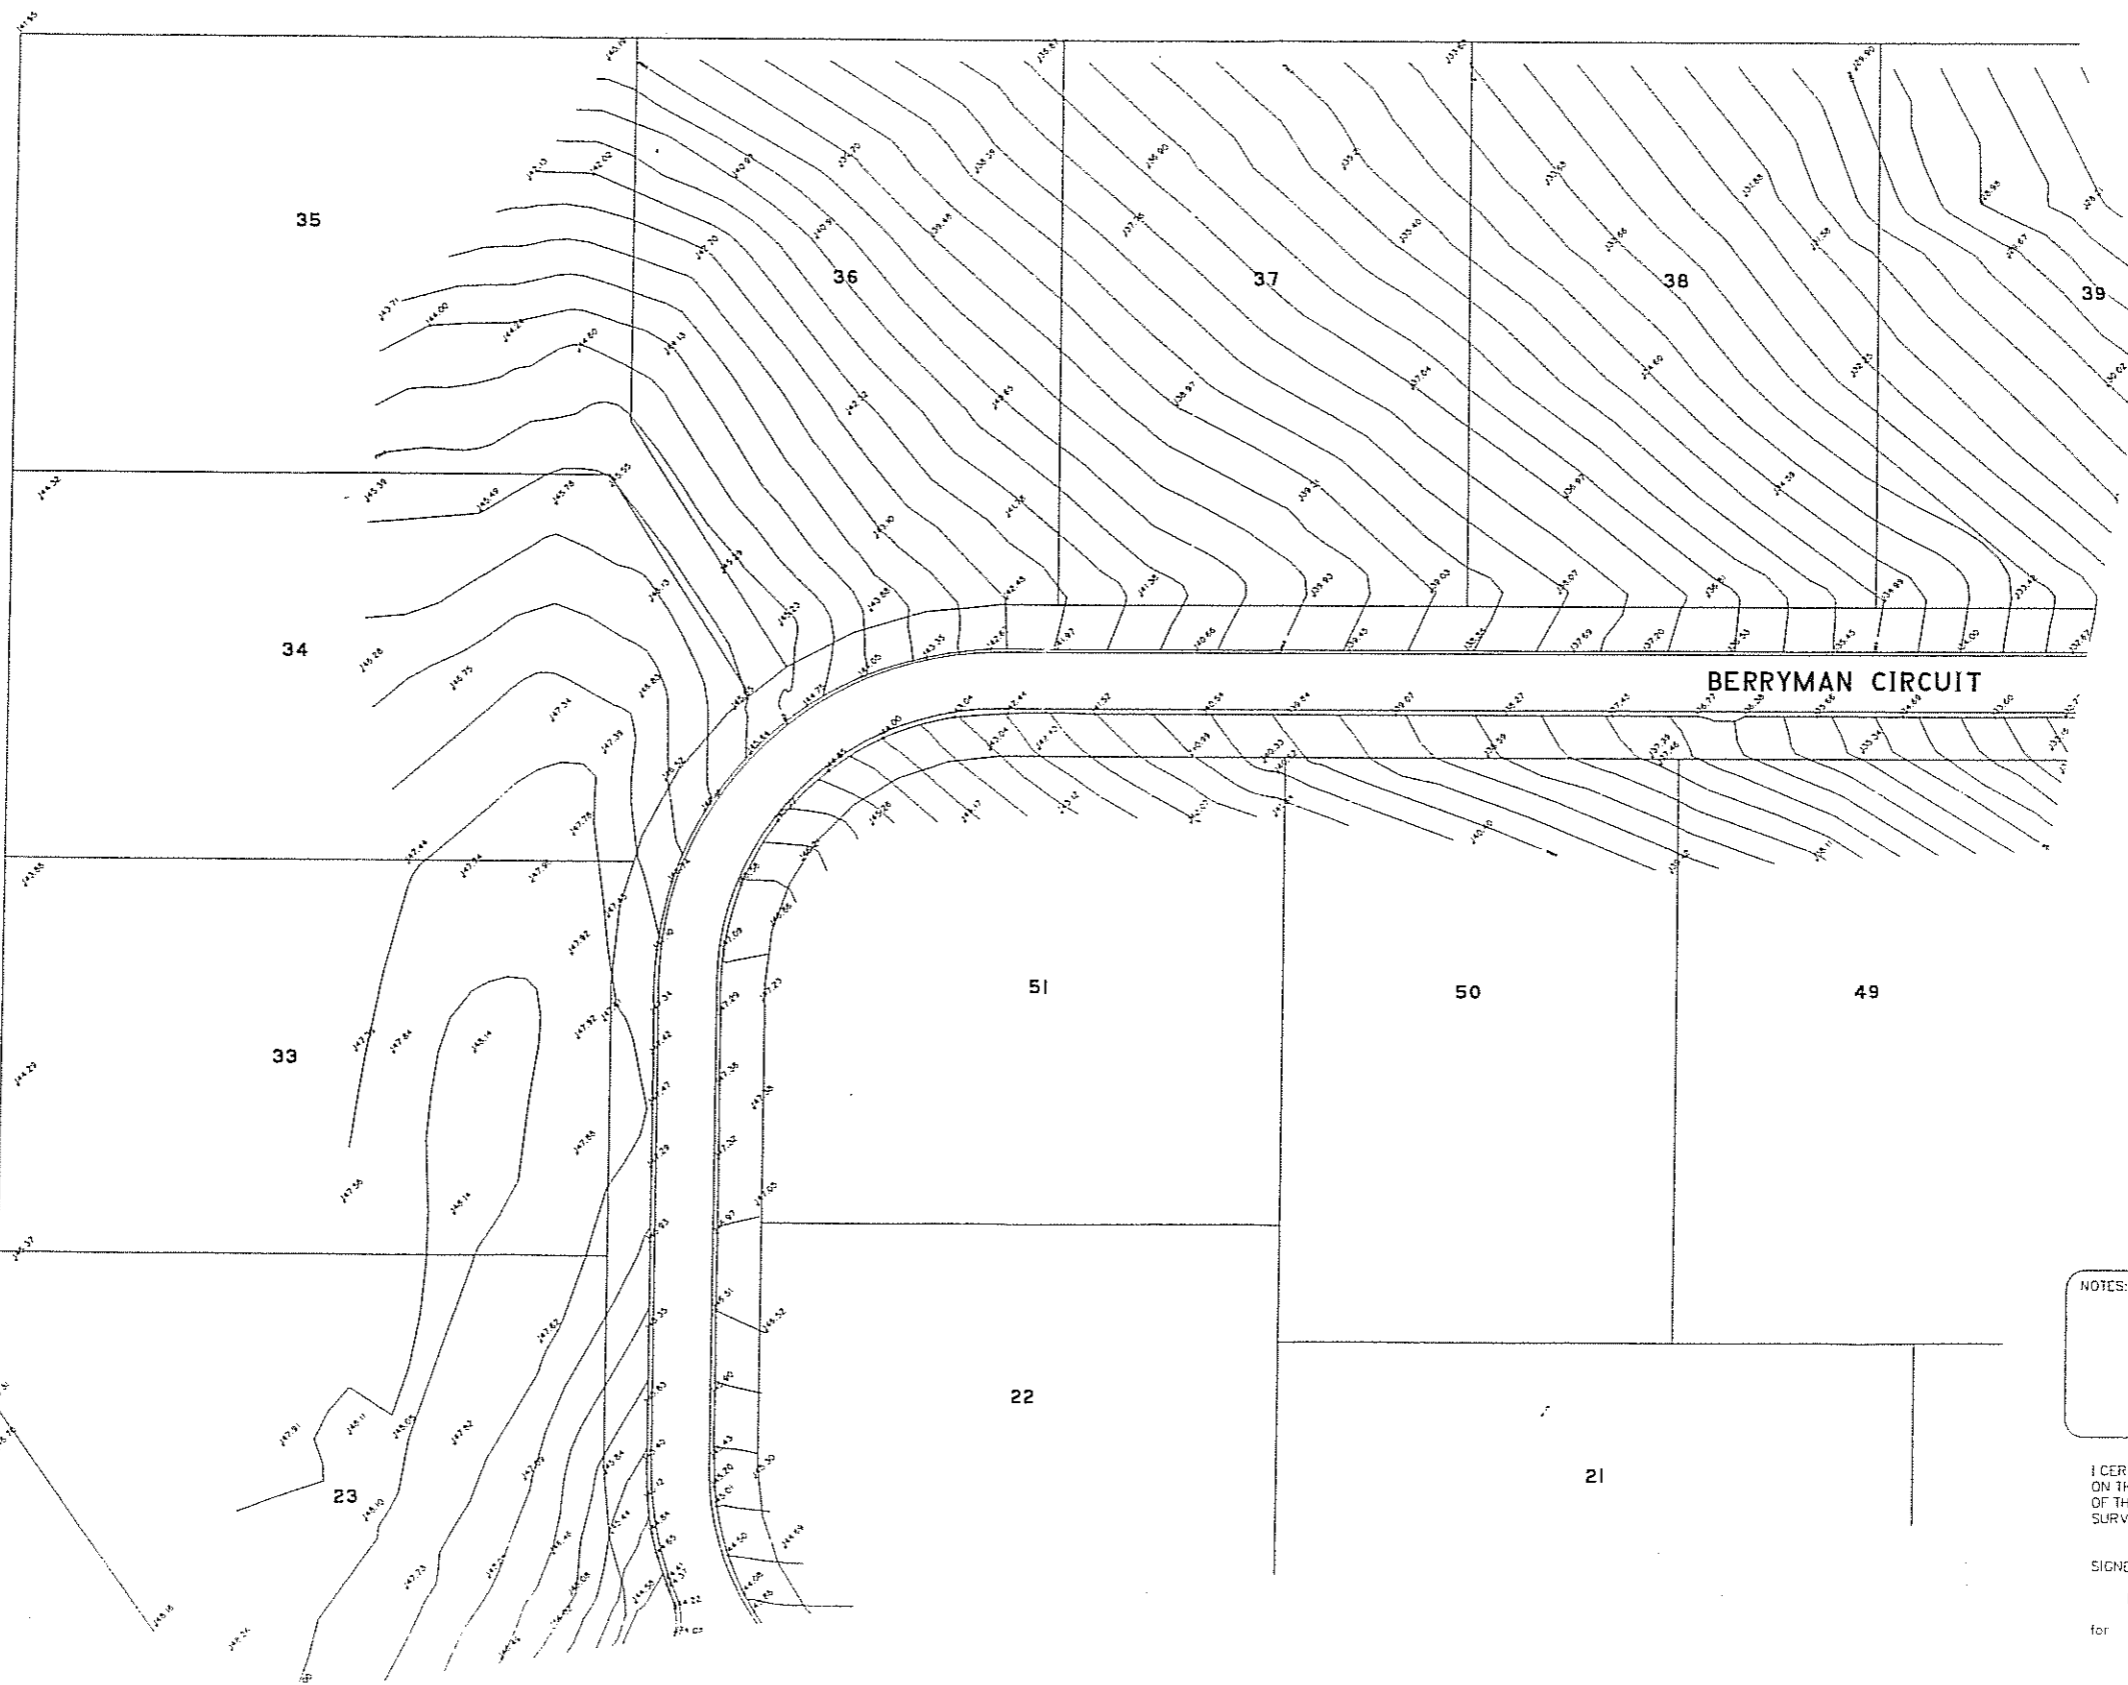

NOTES:

I CERTIFY THAT THE "AS CONSTRUCTED" DETAILS SHOWN ON THIS PLAN ARE A TRUE AND ACCURATE RECORD OF THE WORKS SHOWN HEREON, AS THEY WERE SURVEYED BY US ON SITE.

SIGNED *Donald McCell Mackie* DATE 3/3/09
Donald McCell Mackie (CAD. Surv.)

for Walter Consulting Group.

LEVEL DATUM: AHD v/c PSH 40521
ADOPTED LEVEL: 105.068m AHD Derived
LOCATION:



[Signature]
"WORKS AS CONSTRUCTED"
DATE 6/3/09
RYACON ENGINEERS PTY LTD

LEVITED	BL
DRAWN	BAW
DATE	16/10/08



LICENSED SURVEYORS ■ TOWN PLANNERS
DEVELOPMENT CONSULTANTS
SUITE 1
30 FLORENCE ST. ☎ (07) 36665200
NEWSTEAD P.O. Box 436 F (07) 36665202
NEWCASTLE

DRAWING TITLE

JOB NUMBER	C1340
DRAWING NUMBER	

COMPILED SUBMISSION	23/01/09
ORIGINAL ISSUE	16/10/08



NOTES:

I CERTIFY THAT THE "AS CONSTRUCTED" DETAILS SHOWN ON THIS PLAN ARE A TRUE AND ACCURATE RECORD OF THE WORKS SHOWN HEREON, AS THEY WERE SURVEYED BY US ON SITE.

SIGNED *Donald McCaff Mackle* DATE 3/3/09
Donald McCaff Mackle (CAD. Surv.)

for Walter Consulting Group.

COUNCIL SUBMISSION	7/3/01/09
ORIGINAL ISSUE	16/10/08
REVISIONS	DATE

LEVEL DATUM: AHD vide PSM 40521
ADOPTED LEVEL: 105.068m AHD Derived
LOCATION

0 5 10 15 20 25
SCALE in metres

"WORKS AS CONSTRUCTED"
[Signature]
RYACON ENGINEERS PTY LTD
DATE 6/3/09
RPEO NO 3679

SURVEYED	BC
DRAWN	BAW
DATE	16/10/08
SCALE	1:500



■ LICENSED SURVEYORS ■ TOWN PLANNERS
■ DEVELOPMENT CONSULTANTS

SUITE 1
30 FLORENCE ST.
NEWSTEAD
P.O. Box 436
NEW FARM
QLD 4005

F (07) 36665200
F (07) 36665202
E surveying@walterconsulting.com.au
walterconsulting.com.au

DRAWING TITLE

JOB NUMBER	C1340
DRAWING NUMBER	C1340-04 ISSUE B
	A1



NOTES:

I CERTIFY THAT THE "AS CONSTRUCTED" DETAILS SHOWN ON THIS PLAN ARE A TRUE AND ACCURATE RECORD OF THE WORKS SHOWN HEREON, AS THEY WERE SURVEYED BY US ON SITE.

SIGNED *Donald Mackie* DATE 3/3/09
Donald McCall Mackie (CAD. Surv.)
for Walter Consulting Group.

COUNCIL SUBMISSION	23/07/09
ORIGINAL ISSUE	16/10/08
REVISIONS	DATE

LEVEL DATUM: AHD vide PSM 40521
 ADOPTED LEVEL: 105.066m AHD Derived
 LOCATION

SCALE in metres

"WORKS AS CONSTRUCTED"
[Signature]
 RYAN ENGINEERS PTY LTD
 DATE 6/9/09
 RPEC NO. 3679

SURVEYED	BC
DRAWN	BAW
DATE	16/10/08
SCALE	1:500



LICENSED SURVEYORS ■ TOWN PLANNERS
 ■ DEVELOPMENT CONSULTANTS
 SUITE 1
 30 FLORENCE ST. (07) 36665200
 NEWSTEAD F (07) 36665202
 P.O. Box 436
 NEW FARM
 QLD 4005
 E: surveying@walterconsulting.com.au
www.walterconsulting.com.au

DRAWING TITLE

JOB NUMBER	C1340
DRAWING NUMBER	C1340-04 ISSUE B
	A1



NOTES:

I CERTIFY THAT THE "AS CONSTRUCTED" DETAILS SHOWN ON THIS PLAN ARE A TRUE AND ACCURATE RECORD OF THE WORKS SHOWN HEREON, AS THEY WERE SURVEYED BY US ON SITE.

SIGNED *Donald McCall Mackie* DATE 3/3/09
Donald McCall Mackie (CAD. Surv.)

for Wolter Consulting Group.

COUNCIL SUBMISSION	23/01/09
ORIGINAL ISSUE	16/10/08
REVISIONS	DATE

LEVEL DATUM: AHD vide PSM 48521
 ADOPTED LEVEL: 105.668m AHD Derived
 LOCATION:

SCALE in metres

"WORKS AS CONSTRUCTED"
[Signature]
 RYACON ENGINEERS PTY LTD
 DATE 6/3/09
 RPED NO 3679

SURVEYED	BC
DRAWN	BAW
DATE	16/10/08
SCALE	1:500

■ LICENSED SURVEYORS ■ TOWN PLANNERS
 ■ DEVELOPMENT CONSULTANTS
 SUITE 1
 30 FLORENCE ST. (07) 36665200
 NEWSTEAD P.O. Box 436 F (07) 36665202
 NEW FARM
 QLD 4005
 E: surveying@wolterconsulting.com.au
www.wolterconsulting.com.au

DRAWING TITLE

JOB NUMBER	C1340
DRAWING NUMBER	C1340-04 ISSUE B
	A1



NOTES:

I CERTIFY THAT THE "AS CONSTRUCTED" DETAILS SHOWN ON THIS PLAN ARE A TRUE AND ACCURATE RECORD OF THE WORKS SHOWN HEREON, AS THEY WERE SURVEYED BY US ON SITE.

SIGNED *Donald Mackie* DATE 3/3/09.
Donald McColl Mackie (CAD. Surv.)

for
Walter Consulting Group.


COUNTER SUBMISSION	23/01/09
ORIGINAL ISSUE	16/10/08
REVISIONS	DATE

LEVEL DATUM: AHD vide PSM 40521
 ADOPTED LEVEL: 105.066m AHD Derived
 LOCATION:

SCALE in metres

"WORKS AS CONSTRUCTED"
RYACON ENGINEERS PTY LTD
 DATE 6/3/09
 RPEQ NO. 3679

SURVEYED	BC
DRAWN	BAW
DATE	16/10/08
SCALE	1:500

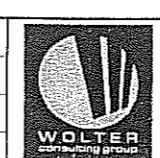


■ LICENSED SURVEYORS ■ TOWN PLANNERS
 ■ DEVELOPMENT CONSULTANTS

SUITE 1
 30 FLORENCE ST. (07) 36665200
 NEWSTEAD P.O. Box 436 F (07) 36665202
 NEW FARM
 QLD 4005
 E surveying@walterconsulting.com.au
walterconsulting.com.au

DRAWING TITLE
JOB NUMBER
C1340
DRAWING NUMBER
C1340-04 ISSUE B

A1

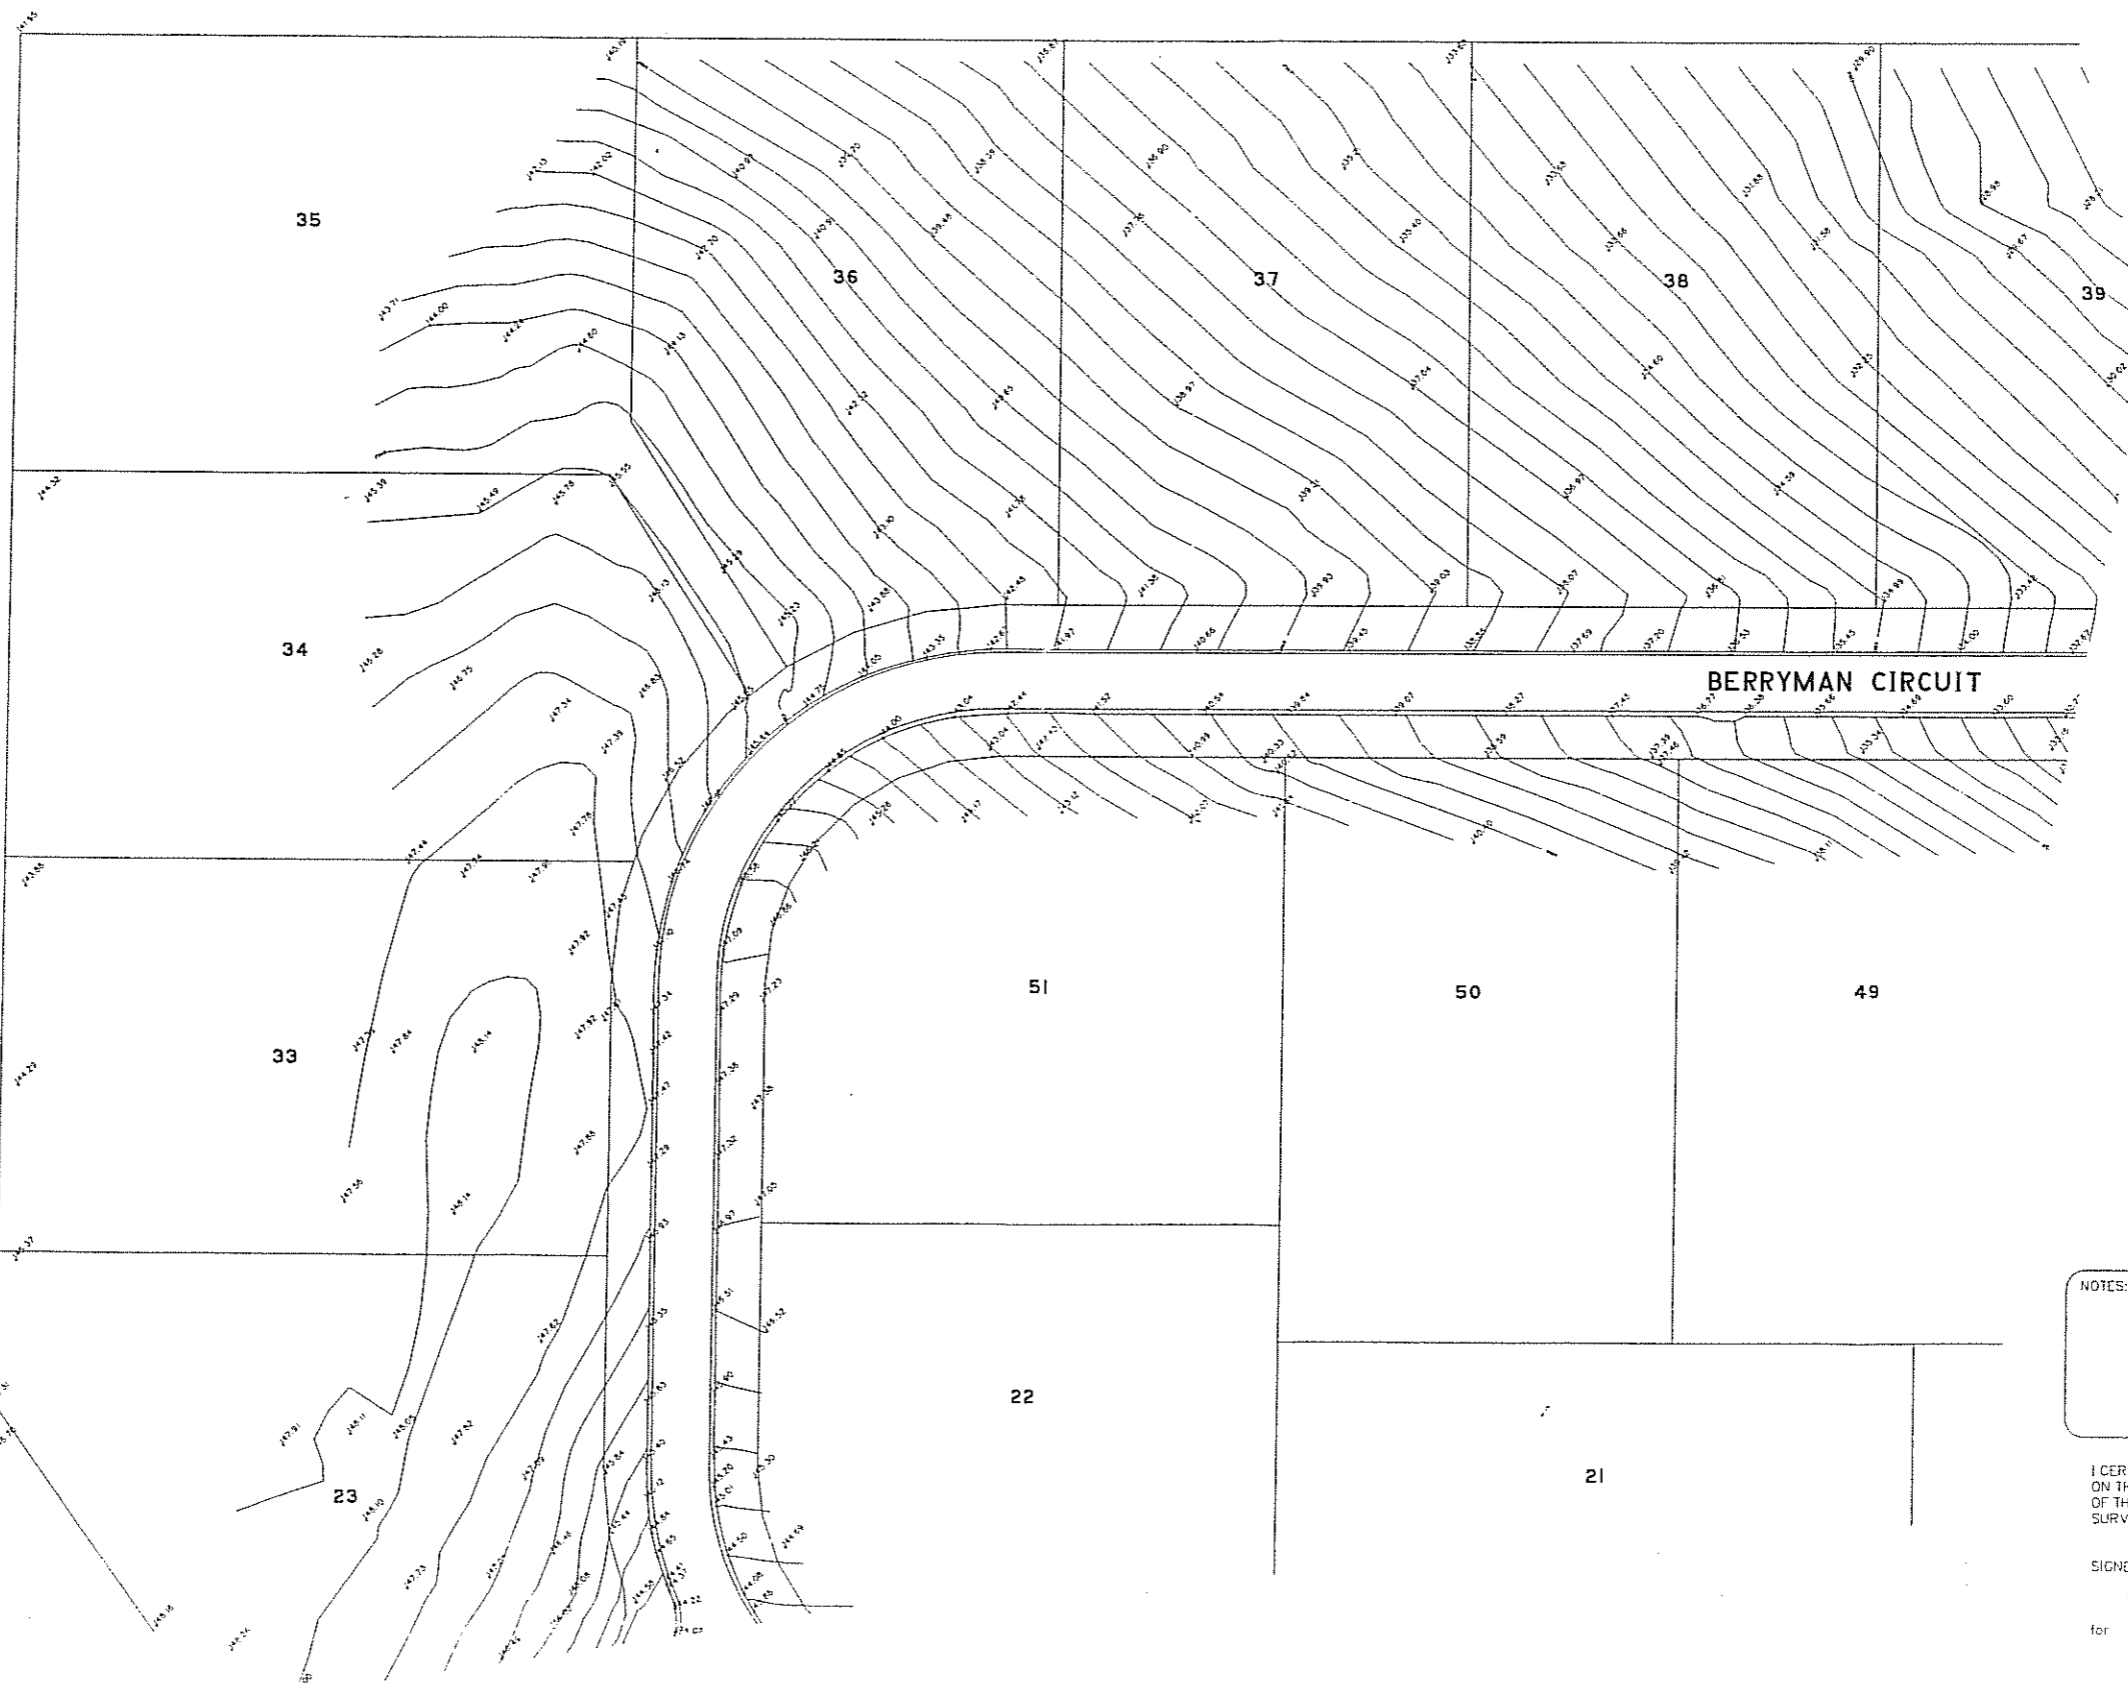


NOTES:

I CERTIFY THAT THE "AS CONSTRUCTED" DETAILS SHOWN ON THIS PLAN ARE A TRUE AND ACCURATE RECORD OF THE WORKS SHOWN HEREON, AS THEY WERE SURVEYED BY US ON SITE.

SIGNED *Donald McCell Mackie* DATE 3/3/09
Donald McCell Mackie (CAD. Surv.)

for Walter Consulting Group.

LEVEL DATUM: AHD v/c PSH 40521
ADOPTED LEVEL: 105.068m AHD Derived
LOCATION:

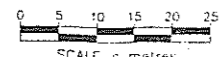

[Signature]
"WORKS AS CONSTRUCTED"
DATE 6/3/09
RYACON ENGINEERS PTY LTD

LEVITED	BL
DRAWN	BAW
DATE	16/10/08



LICENSED SURVEYORS ■ TOWN PLANNERS
DEVELOPMENT CONSULTANTS
SUITE 1
30 FLORENCE ST. ☎ (07) 36665200
NEWSTEAD P.O. Box 436 F (07) 36665202
NEWCASTLE

DRAWING TITLE

JOB NUMBER	C1340
DRAWING NUMBER	

COMPILED SUBMISSION	23/01/09
ORIGINAL ISSUE	16/10/08



NOTES:

I CERTIFY THAT THE "AS CONSTRUCTED" DETAILS SHOWN ON THIS PLAN ARE A TRUE AND ACCURATE RECORD OF THE WORKS SHOWN HEREON, AS THEY WERE SURVEYED BY US ON SITE.

SIGNED *Donald McCaff Mackle* DATE 3/3/09
Donald McCaff Mackle (CAD. Surv.)

for Walter Consulting Group.

SHEET 3 OF 6


COUNCIL SUBMISSION	7/3/01/09
ORIGINAL ISSUE	16/10/08
REVISIONS	DATE

LEVEL DATUM: AHD vide PSM 40521
ADOPTED LEVEL: 105.068m AHD Derived
LOCATION

0 5 10 15 20 25
SCALE in metres

"WORKS AS CONSTRUCTED"
[Signature]
RYACON ENGINEERS PTY LTD
DATE 6/3/09
RPEO NO 3679

SURVEYED	BC
DRAWN	BAW
DATE	16/10/08
SCALE	1:500



■ LICENSED SURVEYORS ■ TOWN PLANNERS
 ■ DEVELOPMENT CONSULTANTS
 SUITE 1
 30 FLORENCE ST. ☎ (07) 36665200
 NEWSTEAD P.O. Box 436 F (07) 36665202
 NEW FARM E-3 surveying@walterconsulting.com.au
 QLD 4005

DRAWING TITLE

JOB NUMBER	C1340
DRAWING NUMBER	C1340-04 ISSUE B
	A1



NOTES:

I CERTIFY THAT THE "AS CONSTRUCTED" DETAILS SHOWN ON THIS PLAN ARE A TRUE AND ACCURATE RECORD OF THE WORKS SHOWN HEREON, AS THEY WERE SURVEYED BY US ON SITE.

SIGNED *Donald Mackie* DATE *3/3/09*
Donald McCall Mackie (CAD. Surv.)
for Walter Consulting Group.

SHEET 4 OF 6

COUNCIL SUBMISSION	23/07/09
ORIGINAL ISSUE	16/10/08
REVISIONS	DATE

LEVEL DATUM: AHD vide PSM 40521
 ADOPTED LEVEL: 105.066m AHD Derived
 LOCATION

SCALE in metres

"WORKS AS CONSTRUCTED"
[Signature]
 RYAN ENGINEERS PTY LTD
 DATE *6/9/09*
 RPEC NO. 3679

SURVEYED	BC
DRAWN	BAW
DATE	16/10/08
SCALE	1:500



LICENSED SURVEYORS ■ TOWN PLANNERS
 ■ DEVELOPMENT CONSULTANTS

SUITE 1
 30 FLORENCE ST. (07) 36665200
 NEWSTEAD F (07) 36665202
 P.O. Box 436
 NEW FARM
 QLD 4005
 E: surveying@walterconsulting.com.au
 W: www.walterconsulting.com.au

DRAWING TITLE

JOB NUMBER	C1340
DRAWING NUMBER	C1340-04 ISSUE B
	A1



NOTES:

I CERTIFY THAT THE "AS CONSTRUCTED" DETAILS SHOWN ON THIS PLAN ARE A TRUE AND ACCURATE RECORD OF THE WORKS SHOWN HEREON, AS THEY WERE SURVEYED BY US ON SITE.

SIGNED *Donald McCall Mackie* DATE 3/3/09
Donald McCall Mackie (CAD. Surv.)

for Wolter Consulting Group.

COUNCIL SUBMISSION	23/01/09
ORIGINAL ISSUE	16/10/08
REVISIONS	DATE

LEVEL DATUM: AHD vide PSM 48521
 ADOPTED LEVEL: 105.668m AHD Derived
 LOCATION:

SCALE in metres

"WORKS AS CONSTRUCTED"
[Signature]
 RYACON ENGINEERS PTY LTD
 DATE 6/3/09
 RPED NO 3679

SURVEYED	BC
DRAWN	BAW
DATE	16/10/08
SCALE	1:500

■ LICENSED SURVEYORS ■ TOWN PLANNERS
 ■ DEVELOPMENT CONSULTANTS
 SUITE 1
 30 FLORENCE ST. (07) 36665200
 NEWSTEAD P.O. Box 436 F (07) 36665202
 NEW FARM
 QLD 4005
 E: surveying@wolterconsulting.com.au
www.wolterconsulting.com.au

DRAWING TITLE

JOB NUMBER	C1340
DRAWING NUMBER	C1340-04 ISSUE B
SCALE	A1



NOTES:

I CERTIFY THAT THE "AS CONSTRUCTED" DETAILS SHOWN ON THIS PLAN ARE A TRUE AND ACCURATE RECORD OF THE WORKS SHOWN HEREON, AS THEY WERE SURVEYED BY US ON SITE.

SIGNED *Donald McColl Mackie* DATE 3/3/09.
Donald McColl Mackie (CAD. Surv.)

for Walter Consulting Group.


COUNTER SUBMISSION	23/01/09
ORIGINAL ISSUE	16/10/08
REVISIONS	DATE

LEVEL DATUM: AHD vide PSM 40521
 ADOPTED LEVEL: 105.066m AHD Derived
 LOCATION:

SCALE in metres

"WORKS AS CONSTRUCTED"
[Signature]
 RYACON ENGINEERS PTY LTD
 DATE 6/3/09
 RPEQ NO. 3679

SURVEYED	BC
DRAWN	BAW
DATE	16/10/08
SCALE	1:500

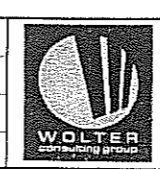

■ LICENSED SURVEYORS ■ TOWN PLANNERS
 ■ DEVELOPMENT CONSULTANTS

SUITE 1
 30 FLORENCE ST. (07) 36665200
 NEWSTEAD P.O. Box 436 F (07) 36665202
 NEW FARM
 QLD 4005
 E surveying@walterconsulting.com.au
www.walterconsulting.com.au

DRAWING TITLE

JOB NUMBER	C1340
DRAWING NUMBER	C1340-04 ISSUE B
	A1