


KENDALL CLOSE  
CH ALL

CBR	4
SURFACE	25mm AC
BASE GR2.1	100
SUB BASE GR2.3	100
L.SUB BASE GR2.5	160

ADELE CLOSE  
CH ALL

CBR	3
SURFACE	25mm AC
BASE GR2.1	100
SUB BASE GR2.3	100
L.SUB BASE GR2.5	225

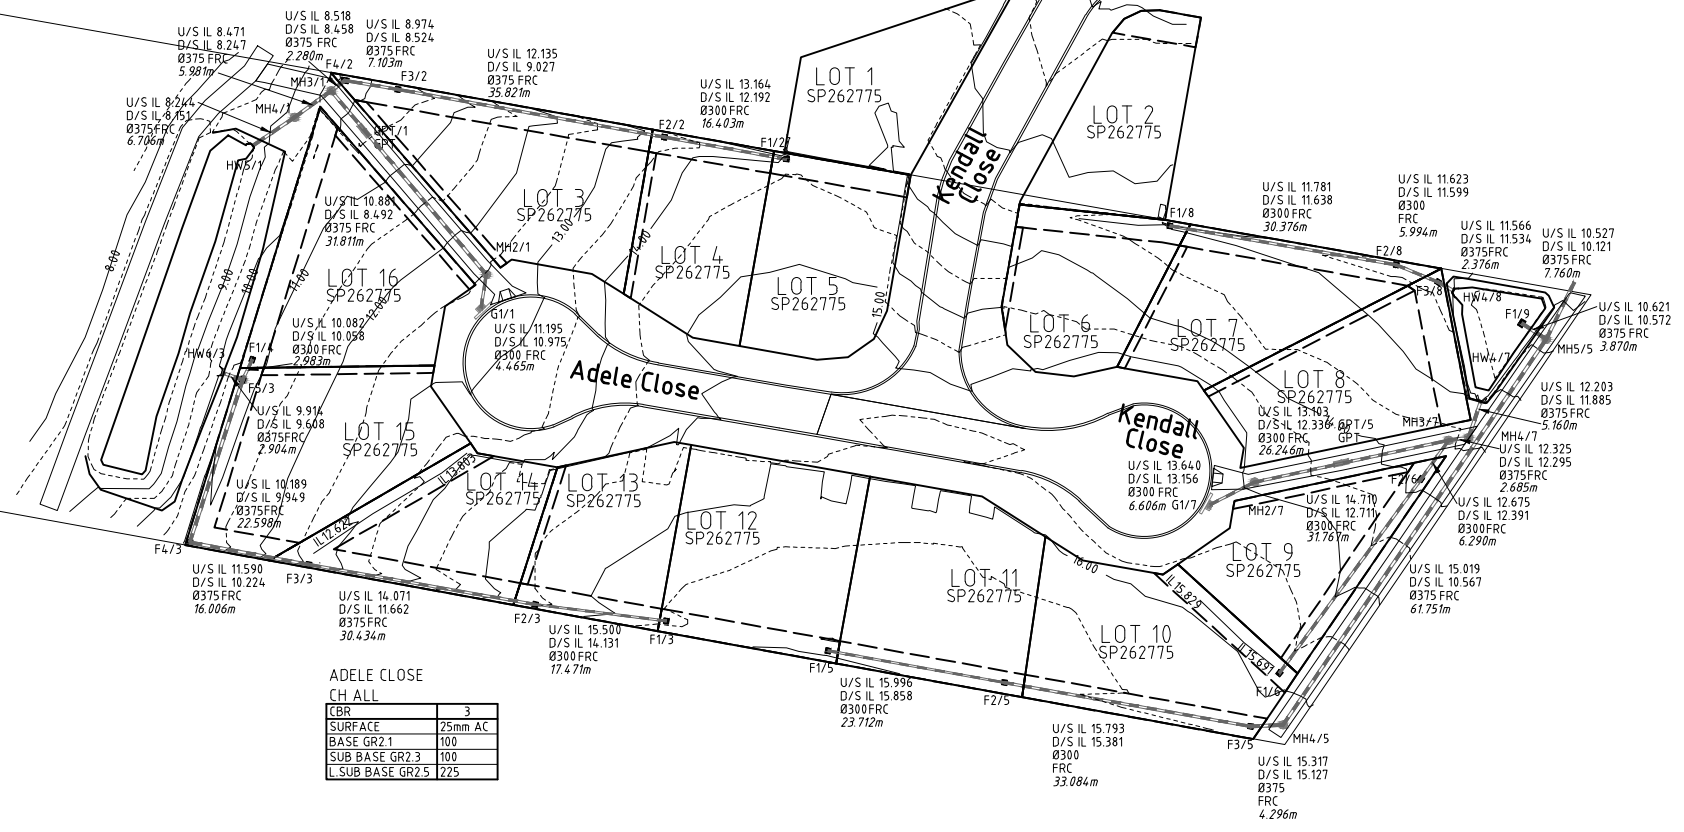

# 36141

**AS CONSTRUCTED**

WE, MURRAY & ASSOCIATES PTY LTD, being registered with the Surveyors Board of QLD hereby:-

- certify the information contained in this drawing is an accurate "as constructed" representation of the works.
- accept responsibility for the "as constructed" information contained in this drawing
- acknowledge the "as constructed" information in the drawing may be relied on by Council and others.

Certification for AS-CONSTRUCTED ...by.....on 19/03/2015  
(CADASTRAL SURVEYOR/DIRECTOR)

DRAWING REVISIONS		REFERENCE DRAWINGS		DESIGN FILE No.	DESIGNED
REV.	REVISION DESCRIPTION	DRG. No.	DESCRIPTION	CONSTRUCT. No.	DATE
A	INITIAL ISSUE			SURVEY FILE No.	DRAWN BH
				FIELD BOOK	DATE Mor-15
				LOG BOOK	CHECKED JMPH
				LEVEL DATUM	DATE
				DATUM	A.H.D.

**THIS WORK WAS PREPARED BY:**  
**HENDRIKS/HOUSE (CAB)**


SCALE 1:500 ORIGINAL SIZE A1

**MORTEON BAY REGIONAL COUNCIL**  
CABOOLTURE DISTRICT OFFICE  
2 HASKING STREET CABOOLTURE QLD 4510  
PO BOX 159 CABOOLTURE QLD 4510  
Telephone: (07) 5433 0100  
Fax: (07) 5433 4000

**91 Petersen Road, MORAYFIELD QLD 4506**

**"AS CONSTRUCTED"**  
**STORMWATER**

MBRC SUBDIVISION REFERENCE	
DA/25812/2011/DA	
No. 1 OF 3 PLANS	
DRAWING NUMBER	REV.
36141	A

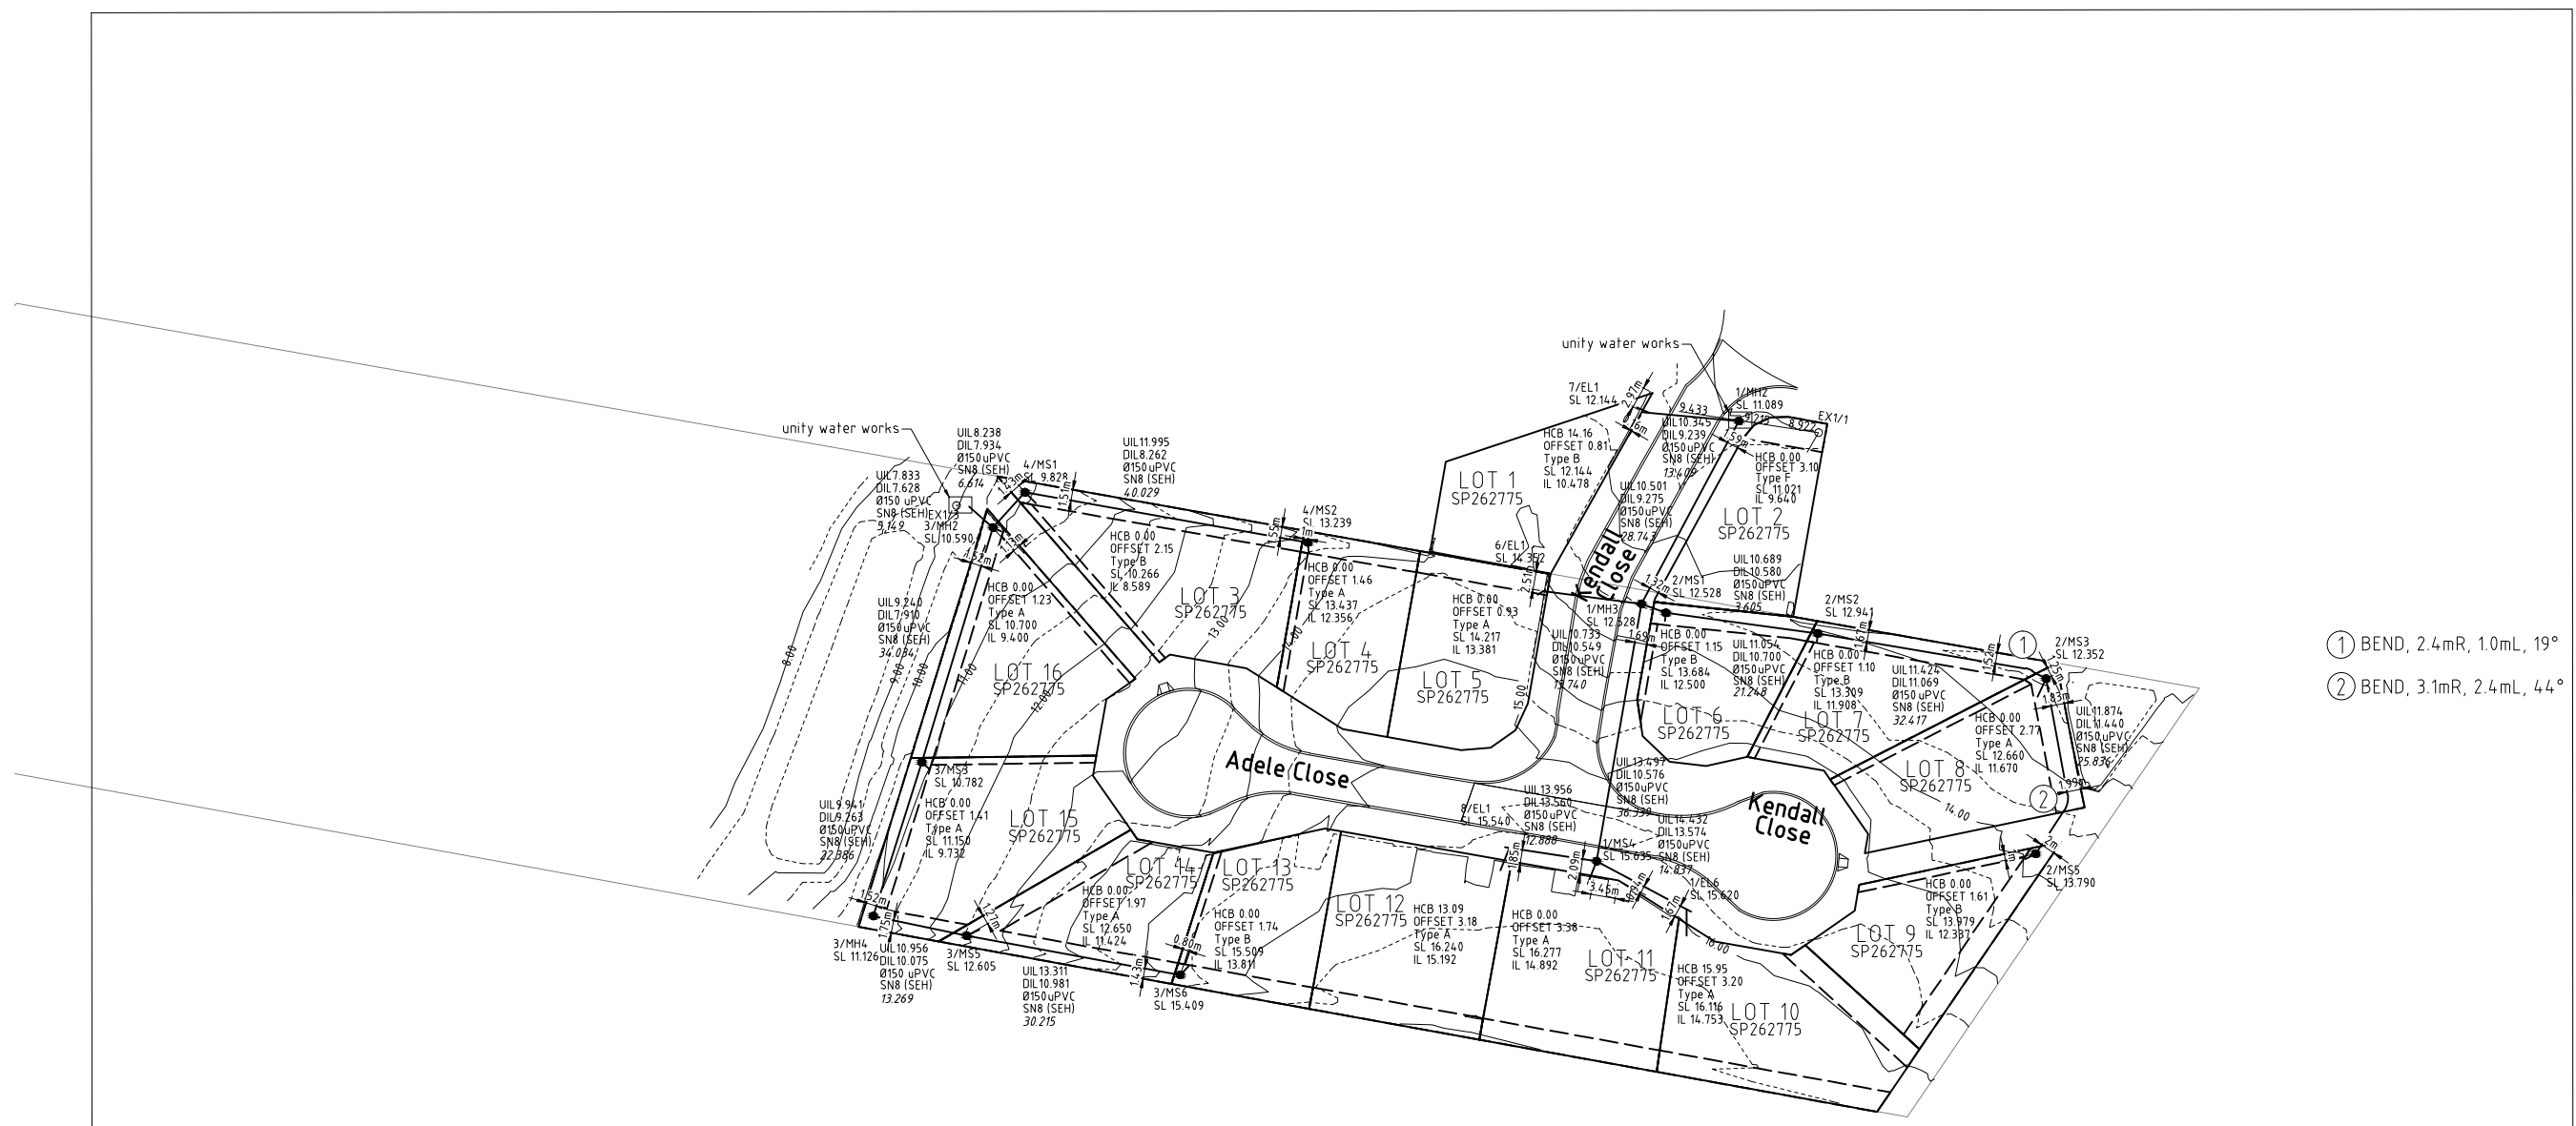

- ① BEND, 2.4mR, 1.0mL, 19°
- ② BEND, 3.1mR, 2.4mL, 44°

# 36141

**AS CONSTRUCTED**

WE, MURRAY & ASSOCIATES PTY LTD, being registered with the Surveyors Board of QLD hereby:-

- certify the information contained in this drawing is an accurate "as constructed" representation of the works.
- accept responsibility for the "as constructed" information contained in this drawing.
- acknowledge the "as constructed" information in the drawing may be relied on by Council and others.

Certification for AS-CONSTRUCTED ...by.....on 19/03/2015  
 (CADASTRAL SURVEYOR/DIRECTOR)

DRAWING REVISIONS		REFERENCE DRAWINGS		DESIGN FILE No.	DESIGNED
REV.	REVISION DESCRIPTION	DRG. No.	DESCRIPTION	CONSTRUCT. No.	DATE
A	INITIAL ISSUE			SURVEY FILE No.	DRAWN BH
				FIELD BOOK	DATE Mor-15
				LOG BOOK	CHECKED JMPH
				LEVEL DATUM	DATE
				DATUM	A.H.D.

**THIS WORK WAS PREPARED BY:**  
**HENDRIKS/HOUSE (CAB)**


SCALE 1:500 ORIGINAL SIZE A1

**MORTEON BAY REGIONAL COUNCIL**  
 CABOOLTURE DISTRICT OFFICE  
 2 HASKING STREET CABOOLTURE QLD 4510  
 PO BOX 159 CABOOLTURE QLD 4510  
 Telephone: (07) 5433 0100  
 Fax: (07) 5433 4000

**91 Petersen Road, MORAYFIELD QLD 4506**

**"AS CONSTRUCTED"**  
**SEWER**

MBRC SUBDIVISION REFERENCE	
DA/25812/2011/DA	
No. 2 OF 3 PLANS	
DRAWING NUMBER	REV.
<b>36141</b>	A

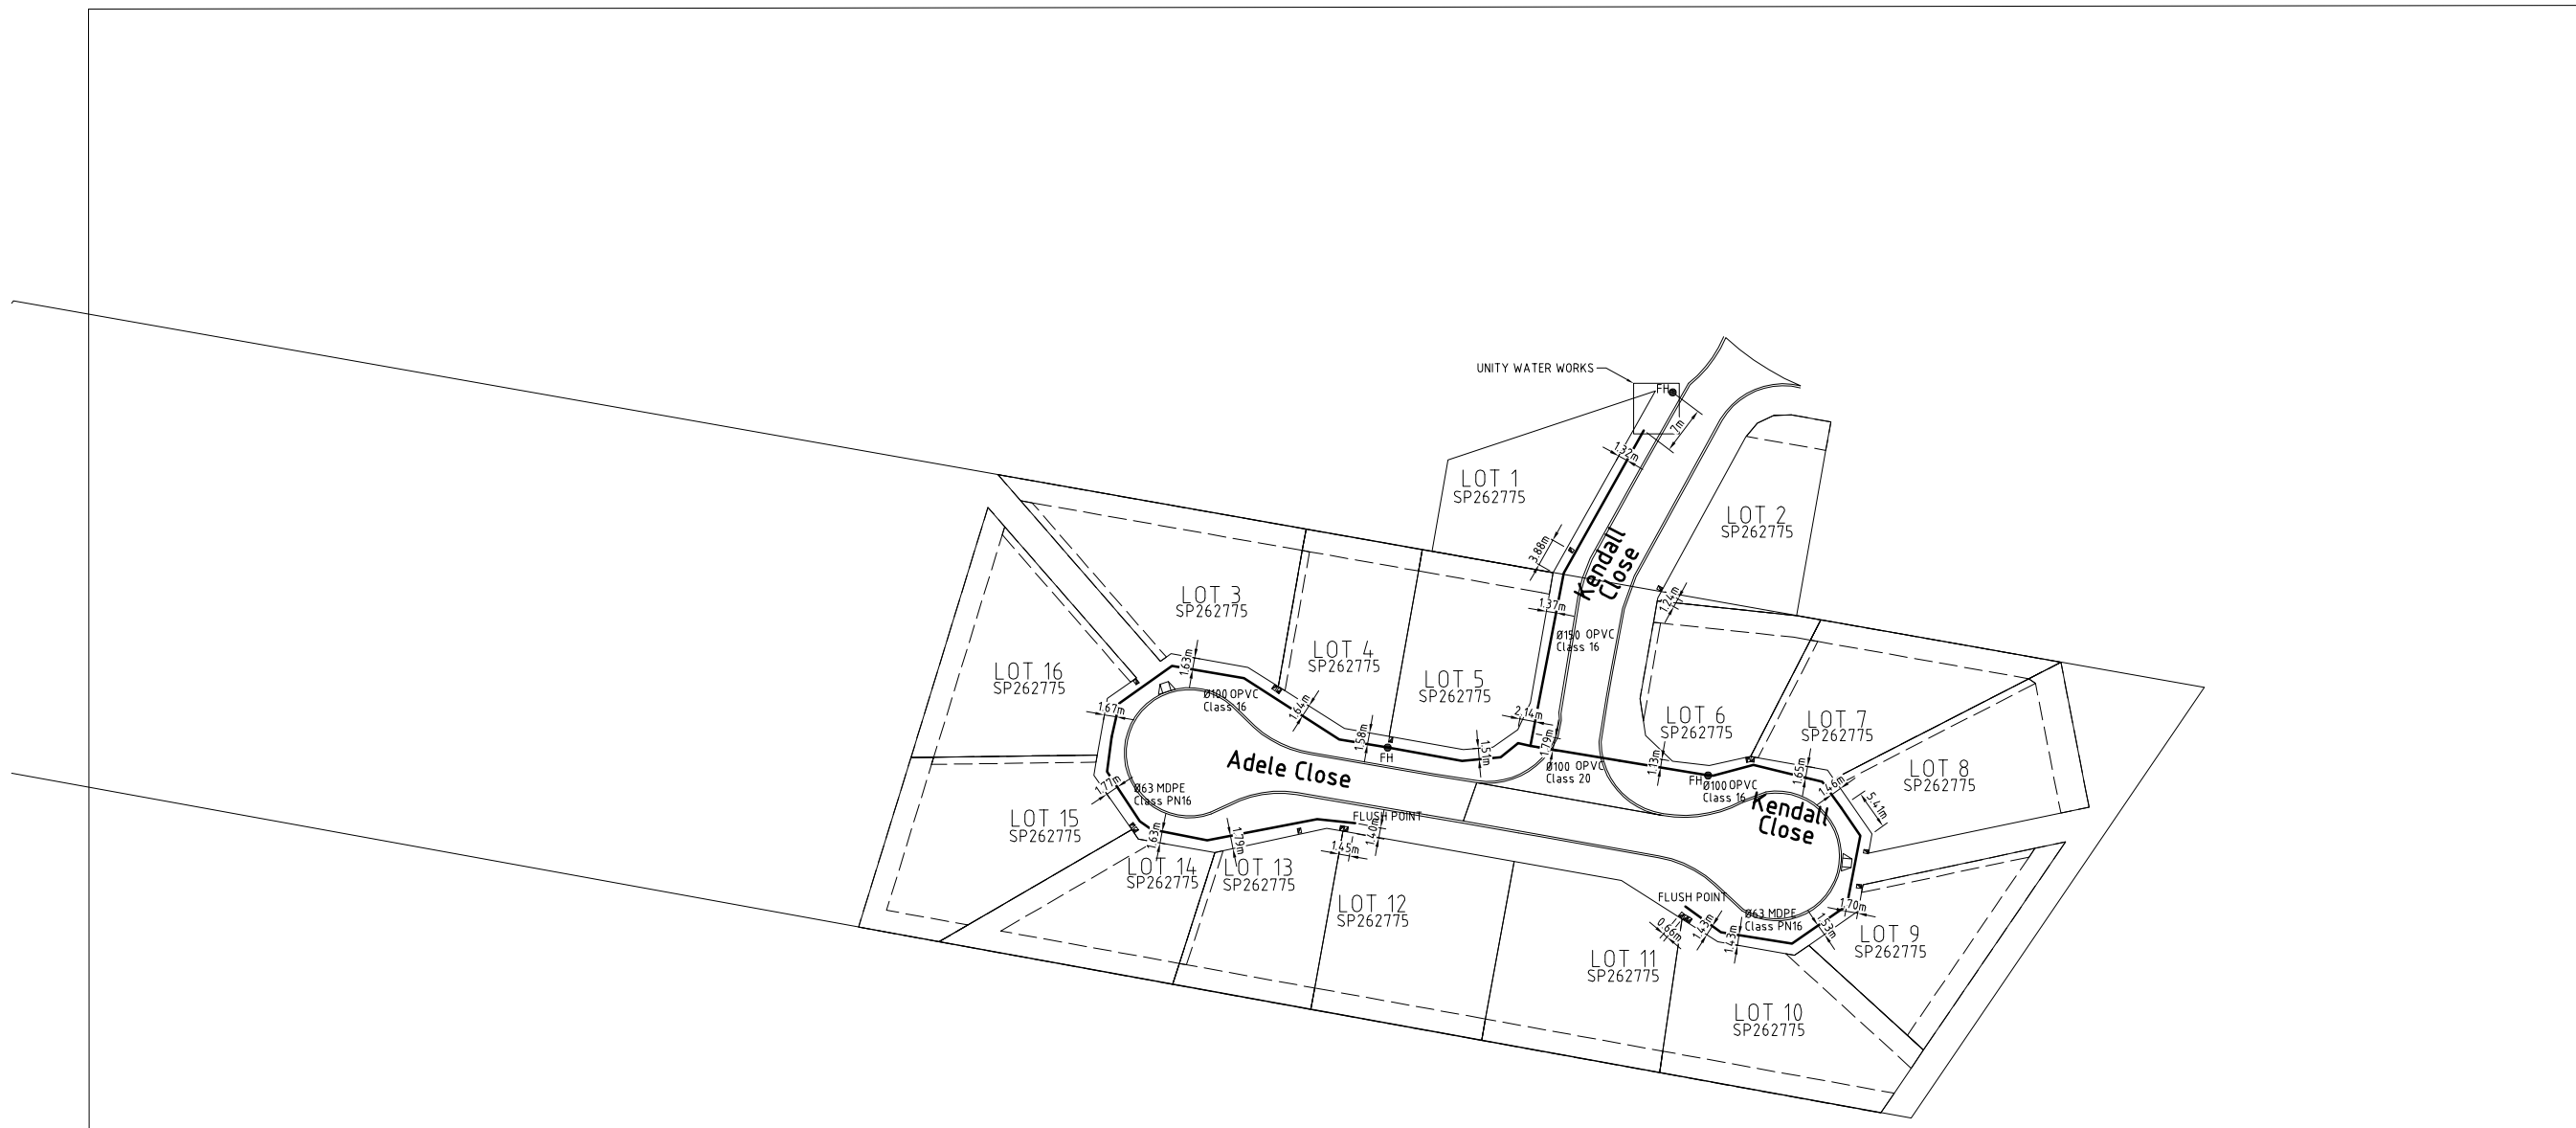

# 36141

## AS CONSTRUCTED

WE, MURRAY & ASSOCIATES PTY LTD, being registered with the Surveyors Board of QLD hereby:-

- certify the information contained in this drawing is an accurate "as constructed" representation of the works.
- accept responsibility for the "as constructed" information contained in this drawing.
- acknowledge the "as constructed" information in the drawing may be relied on by Council and others.

Certification for AS-CONSTRUCTED ...by.....on 19/03/2015  
(CADASTRAL SURVEYOR/DIRECTOR)

### WATER TABLE LEGEND

FH	FIRE HYDRANTS
V	SLUICE VALVES
SV	SCOUR VALVES
DEC	DEAD END CAP

DRAWING REVISIONS		REFERENCE DRAWINGS		DESIGN FILE No.	DESIGNED
REV.	REVISION DESCRIPTION	DRG. No.	DESCRIPTION	CONSTRUCT. No.	DATE
A	INITIAL ISSUE			SURVEY FILE No.	DRAWN BH
				FIELD BOOK	DATE Mar-15
				LOG BOOK	CHECKED JMPH
				LEVEL DATUM	DATE
				DATUM	

THIS WORK WAS PREPARED BY:  
**HENDRIKS/HOUSE (CAB)**



SCALE 1:500 ORIGINAL SIZE A1

**MORAY BAY REGIONAL COUNCIL**  
CABOOLTURE DISTRICT OFFICE  
2 HASKING STREET CABOOLTURE QLD 4510  
PO BOX 159 CABOOLTURE QLD 4510  
Telephone: (07) 5433 0100  
Fax: (07) 5433 4000

91 Petersen Road, MORAYFIELD  
QLD 4506

"AS CONSTRUCTED"  
WATER

MBRC SUBDIVISION REFERENCE

DA/25812/2011/DA

No. 3 OF 3 PLANS

DRAWING NUMBER REV.

36141 A